
REV:	Stage: As Built
B	Qty. 1off

REVISION HISTORY:

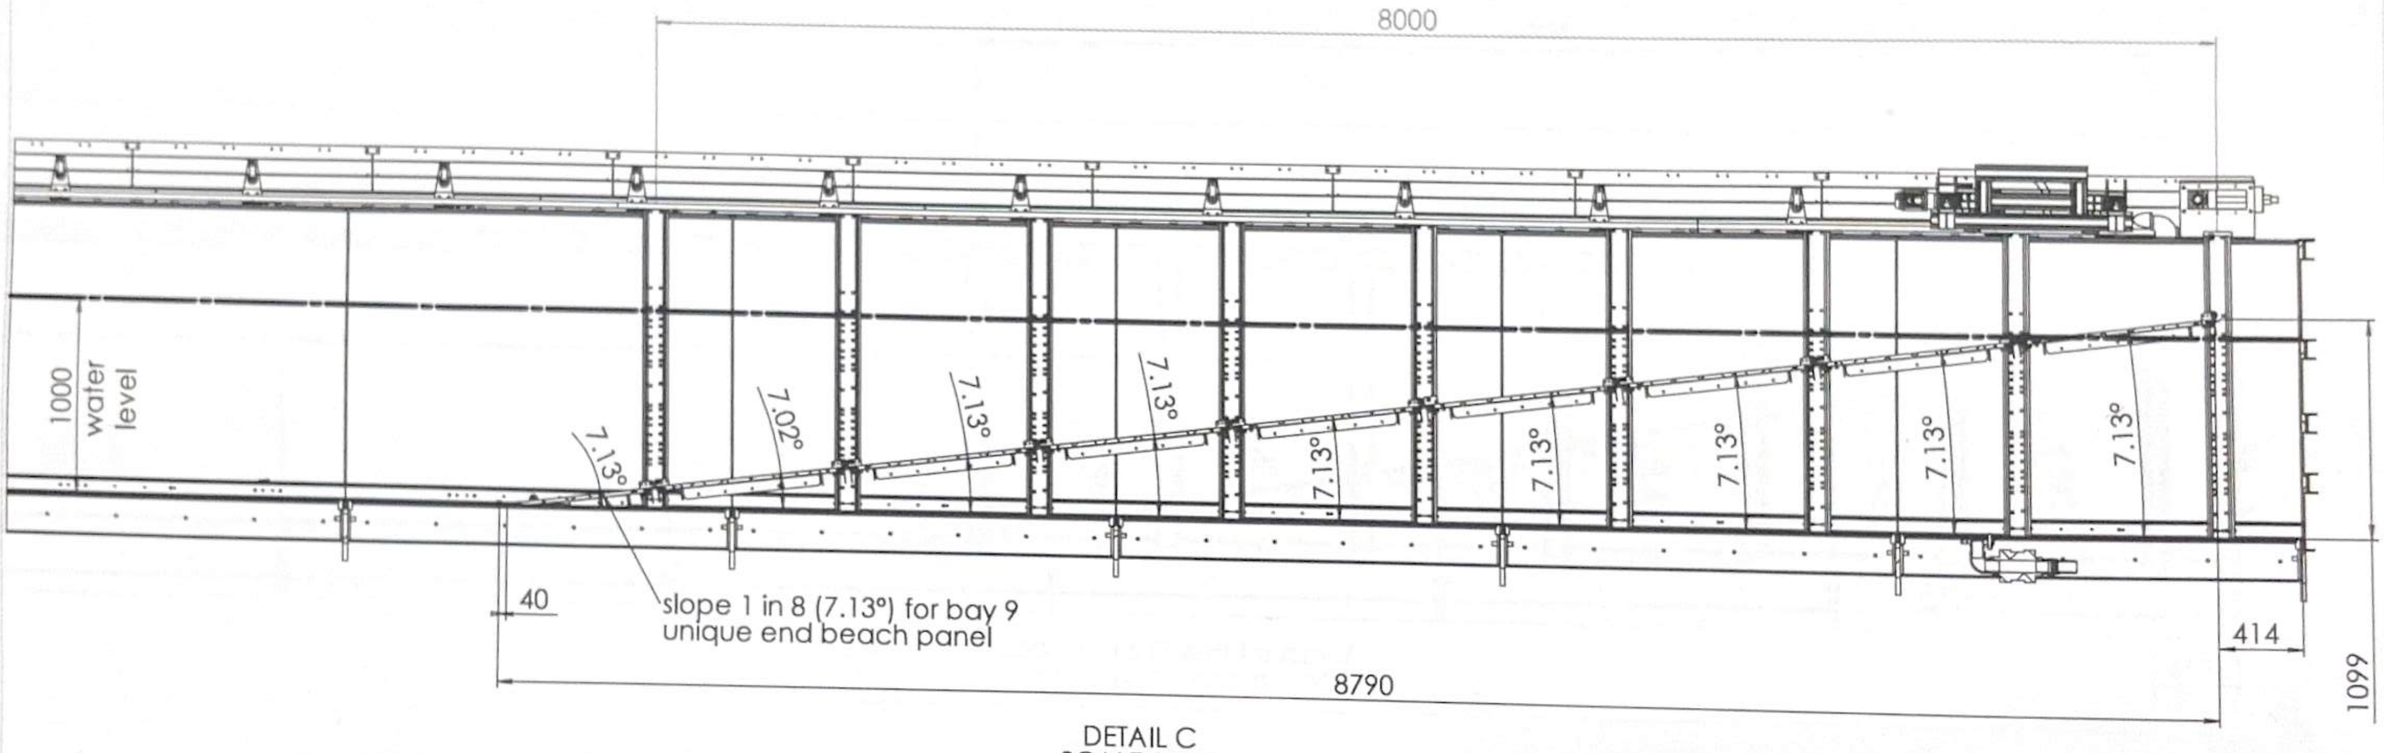

DETAIL C
SCALE 1 : 30

slope 1 in 8


Uses 8 standard beach panels and 1 unique (1 in 8 slope) end beach panel

Dimensions are for information only

DWG NO. North Carolina beach		NCW-GA02
DATE: 03/07/2023	SHEET 3 OF 6	
MATERIAL: FINISH:	WEIGHT (kg): 215162.9	
SCALE: 1:100	All rights reserved. Drawings and specifications are the property and copyright of Edinburgh Designs Ltd. and shall not be reproduced without written agreement of Edinburgh Designs Ltd.	
PROJECTION: Third Angle A3		EDINBURGH DESIGNS

REV:	Stage: As Built
B	Qty. 1off

REVISION HISTORY:

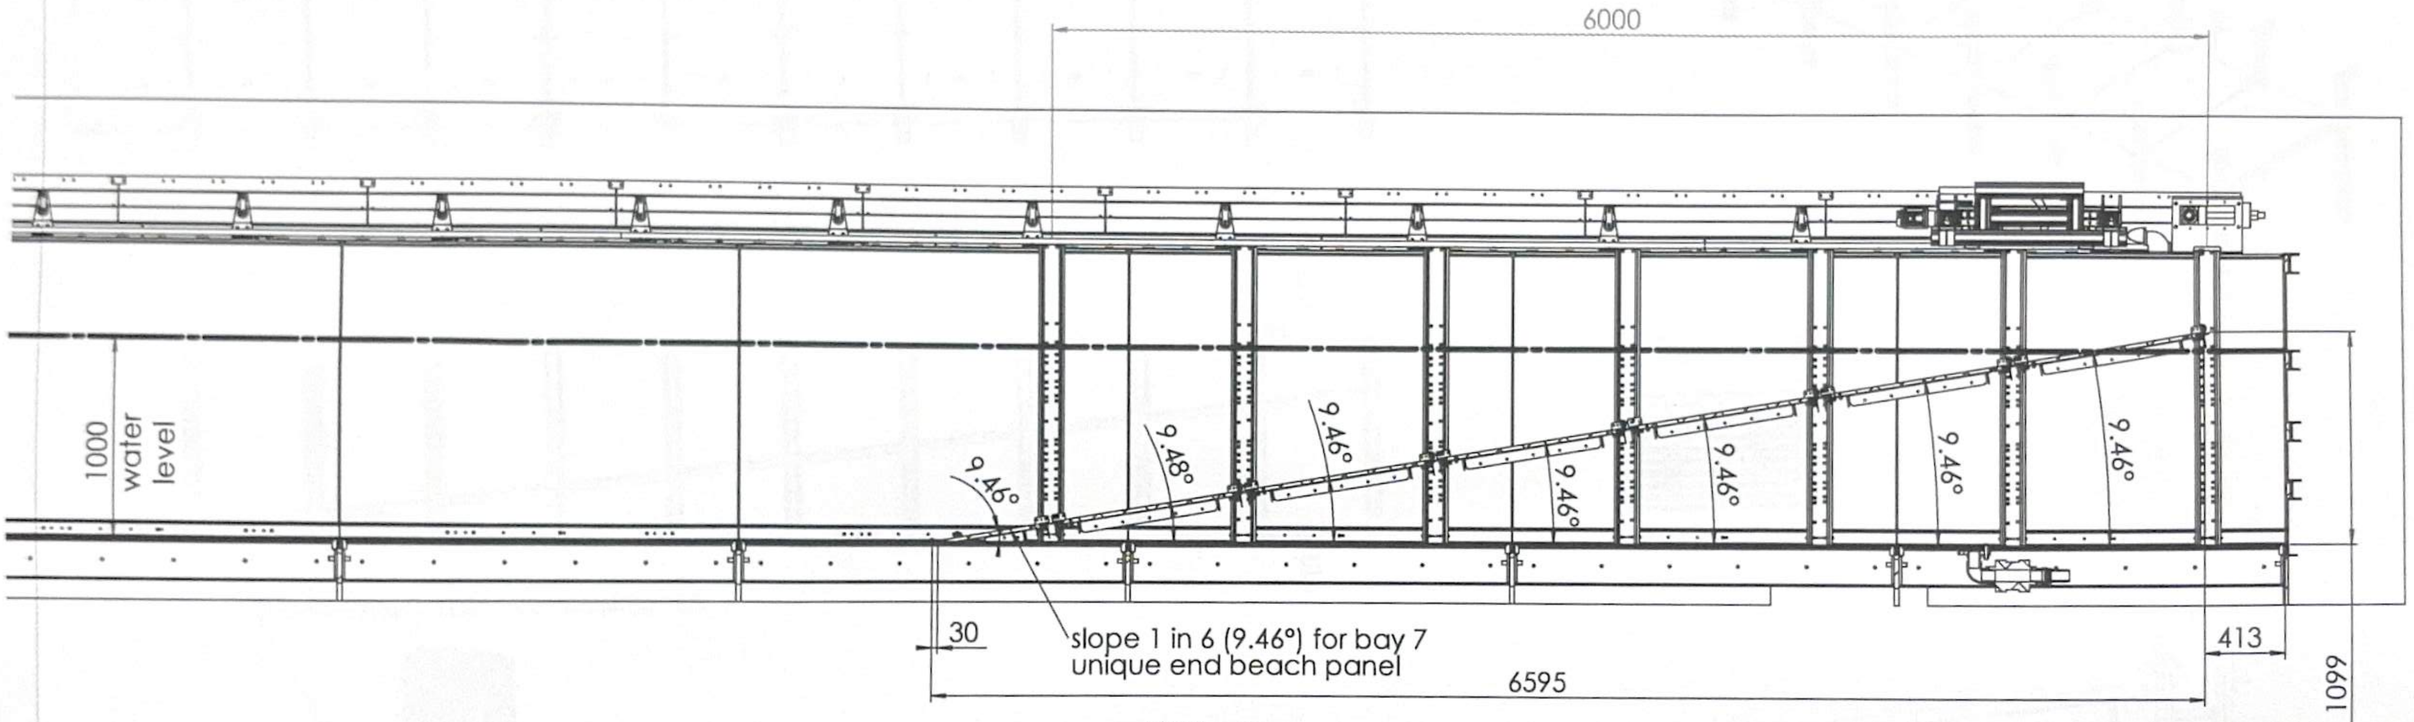

DETAIL D
SCALE 1 : 30

slope 1 in 6

Uses 6 standard beach panels and 1 unique (1 in 6 slope) end beach panel


Dimensions are for information only

DWG NO. North Carolina beach		NCW-GA02
DATE: 03/07/2023	SHEET 4 OF 6	
MATERIAL:	WEIGHT (kg): 215162.9	
FINISH:	All rights reserved. Drawings and specifications are the property and copyright of Edinburgh Designs Ltd. and shall not be reproduced without written agreement of Edinburgh Designs Ltd.	
SCALE: 1:100		
PROJECTION: Third Angle	A3	


EDINBURGH DESIGNS


REV:	Stage: As Built
B	Qty.


REVISION HISTORY:

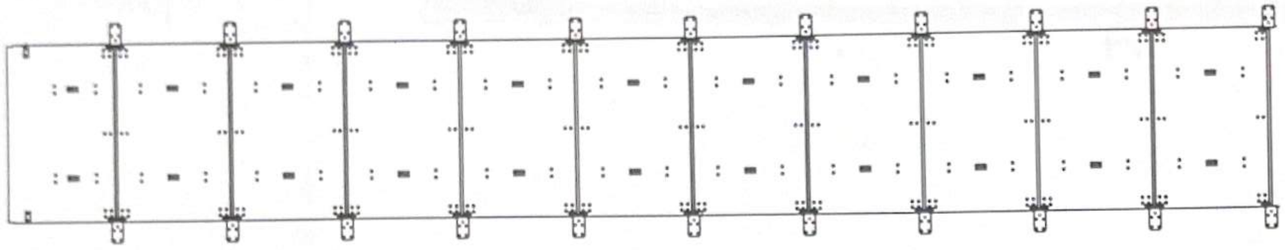


slope 1 in 10 shown

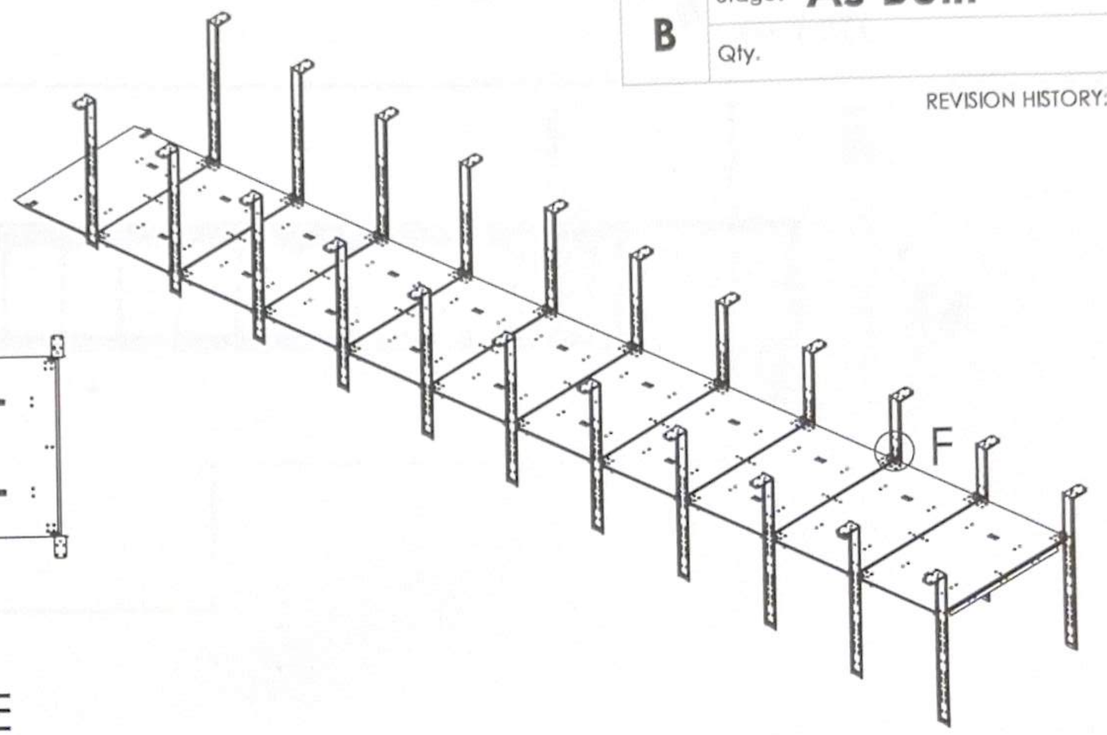

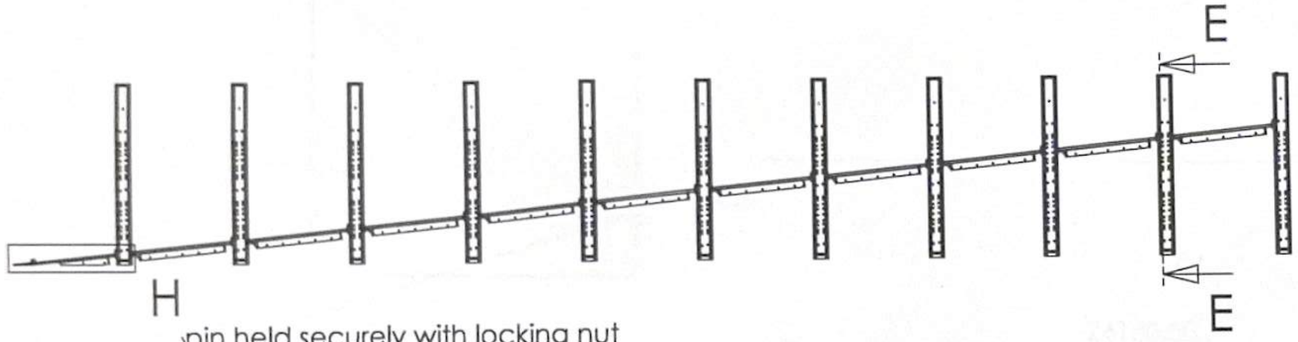


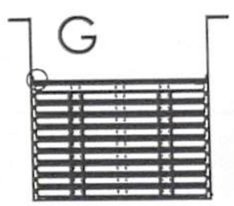


SECTION E-E

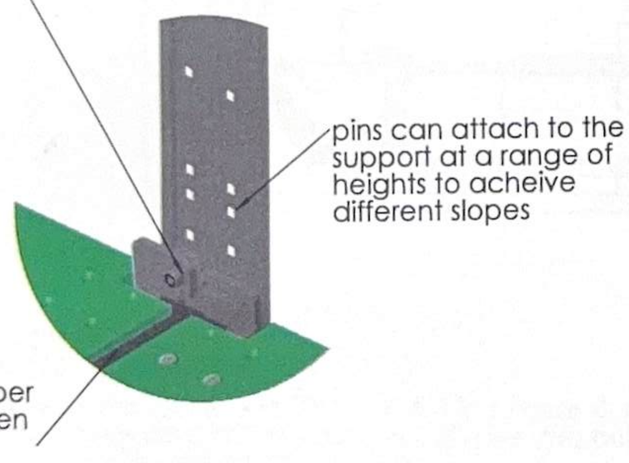

DETAIL F
SCALE 1 : 5

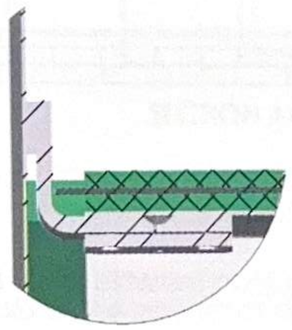

DETAIL G
SCALE 1 : 3

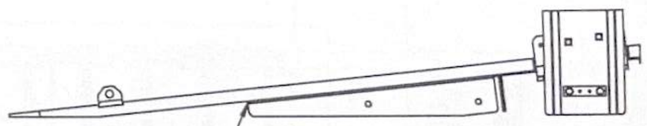

DETAIL H
SCALE 1 : 10


Dimensions are for information only

DWG NO.	North Carolina beach	NCW-GA02
DATE: 03/07/2023	SHEET 5 OF 6	
MATERIAL:	WEIGHT (kg): 215162.9	
FINISH:	All rights reserved. Drawings and specifications are the property and copyright of Edinburgh Designs Ltd. and shall not be reproduced without written agreement of Edinburgh Designs Ltd.	
SCALE: 1:50		
PROJECTION: Third Angle	A3	

EDINBURGH DESIGNS

REV:	Stage: As Built
B	Qty. 1off

REVISION HISTORY:

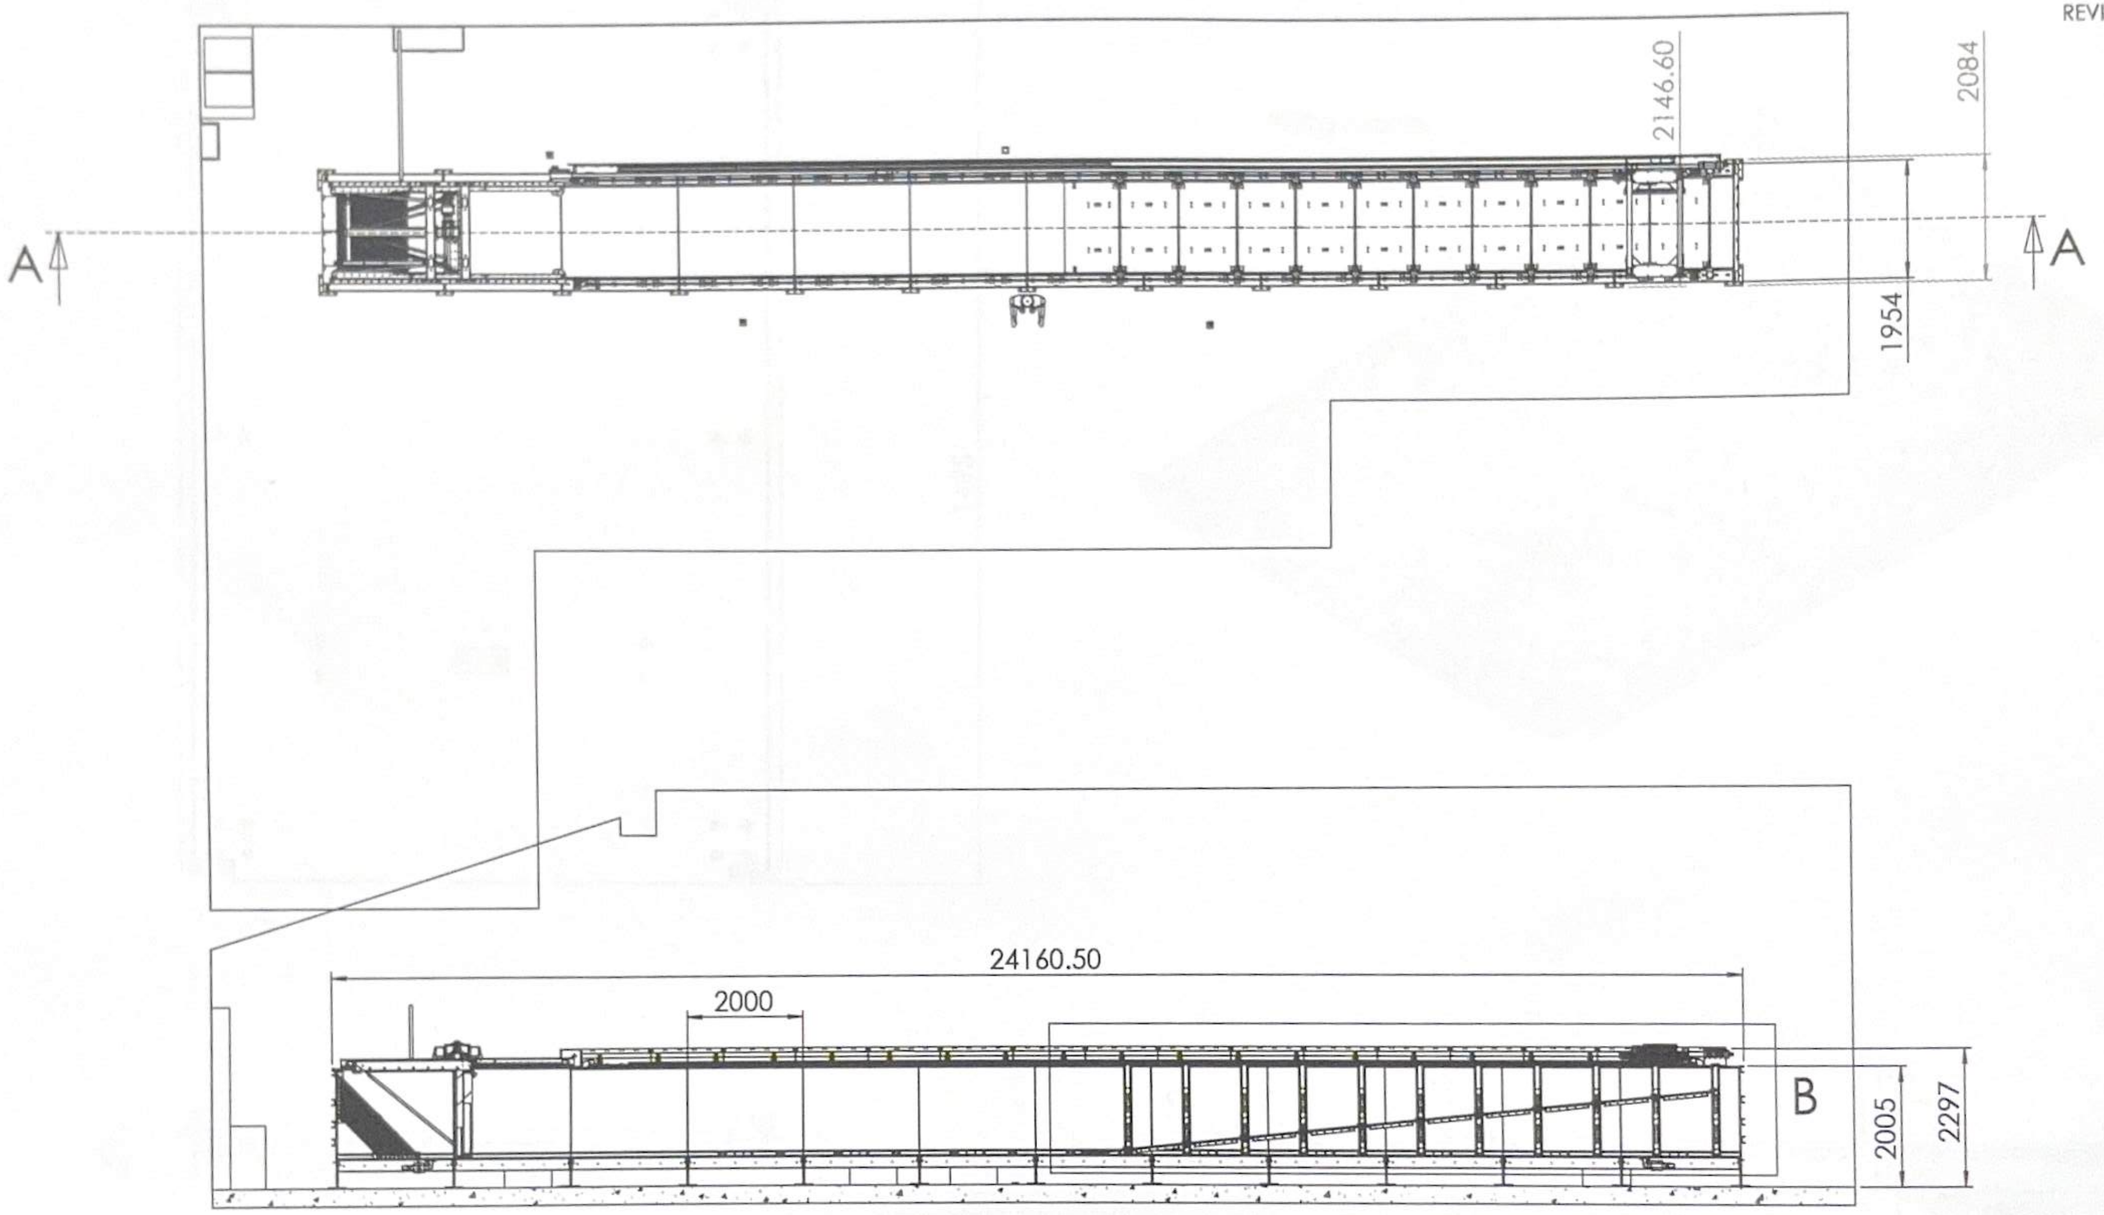

SECTION A-A

beach can be reconfigured to 1 in 10, 1 in 8 & 1 in 6 linear slopes plus many different configurations
beach panels are supported at the sides through pins into holes and slots - the pattern of holes/slots determines which configurations are possible
supports are identical - 10 identical panels are to be supplied, plus three unique end panels


Dimensions are for information only


DWG NO.	North Carolina beach	NCW-GA02
DATE: 03/07/2023	SHEET 1 OF 6	
MATERIAL:	WEIGHT (kg): 215162.9	
FINISH:	All rights reserved. Drawings and specifications are the property and copyright of Edinburgh Designs Ltd. and shall not be reproduced without written agreement of Edinburgh Designs Ltd.	
SCALE: 1:100		
PROJECTION: Third Angle	A3	


EDINBURGH DESIGNS

REV:	Stage: As Built
B	Qty.


REVISION HISTORY:

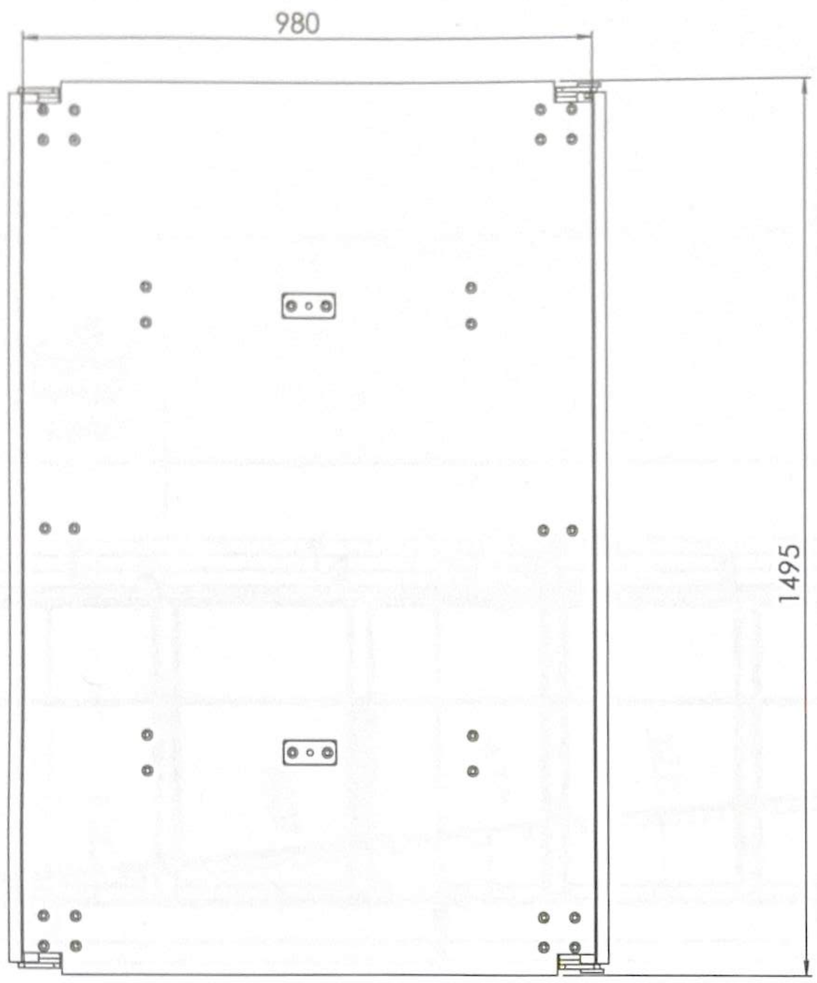

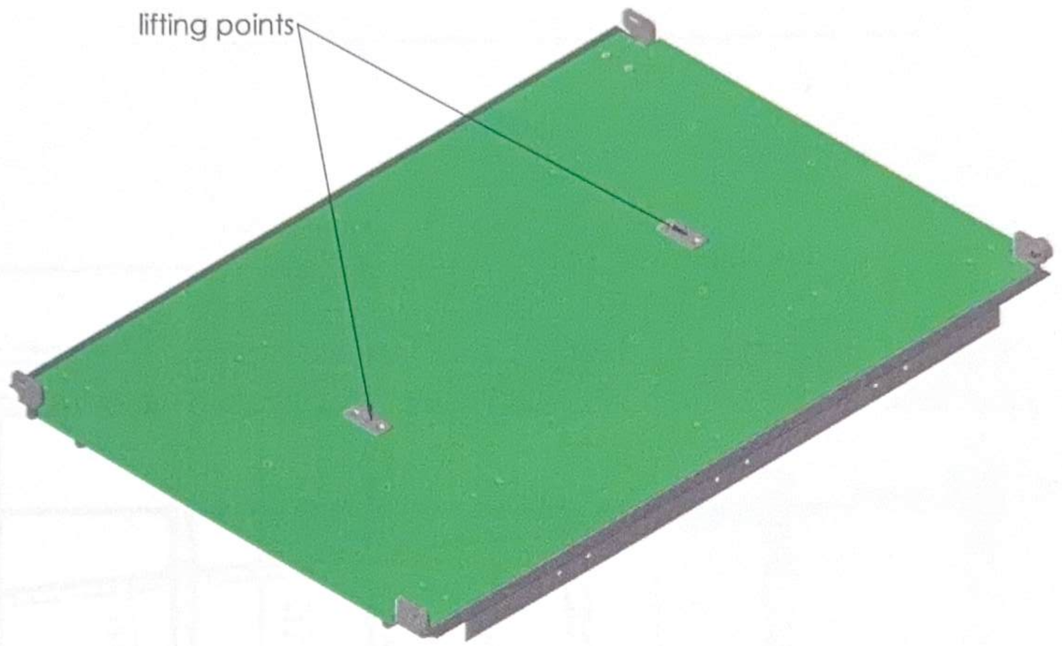

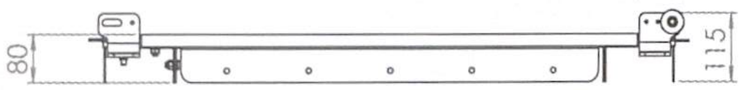

standard panel shown

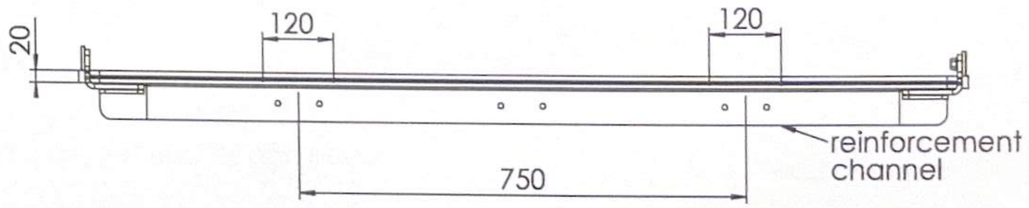

Dimensions are for information only

DWG NO. North Carolina beach NCW-GA02

DATE: 03/07/2023 | SHEET 6 OF 6

MATERIAL:

FINISH:

WEIGHT (kg): 215162.9

SCALE: 1:10


PROJECTION: Third Angle | A3

All rights reserved. Drawings and specifications are the property and copyright of Edinburgh Designs Ltd. and shall not be reproduced without written agreement of Edinburgh Designs Ltd.

EDINBURGH DESIGNS

REV:	Stage: **As Built**
B	Qty.

REVISION HISTORY:

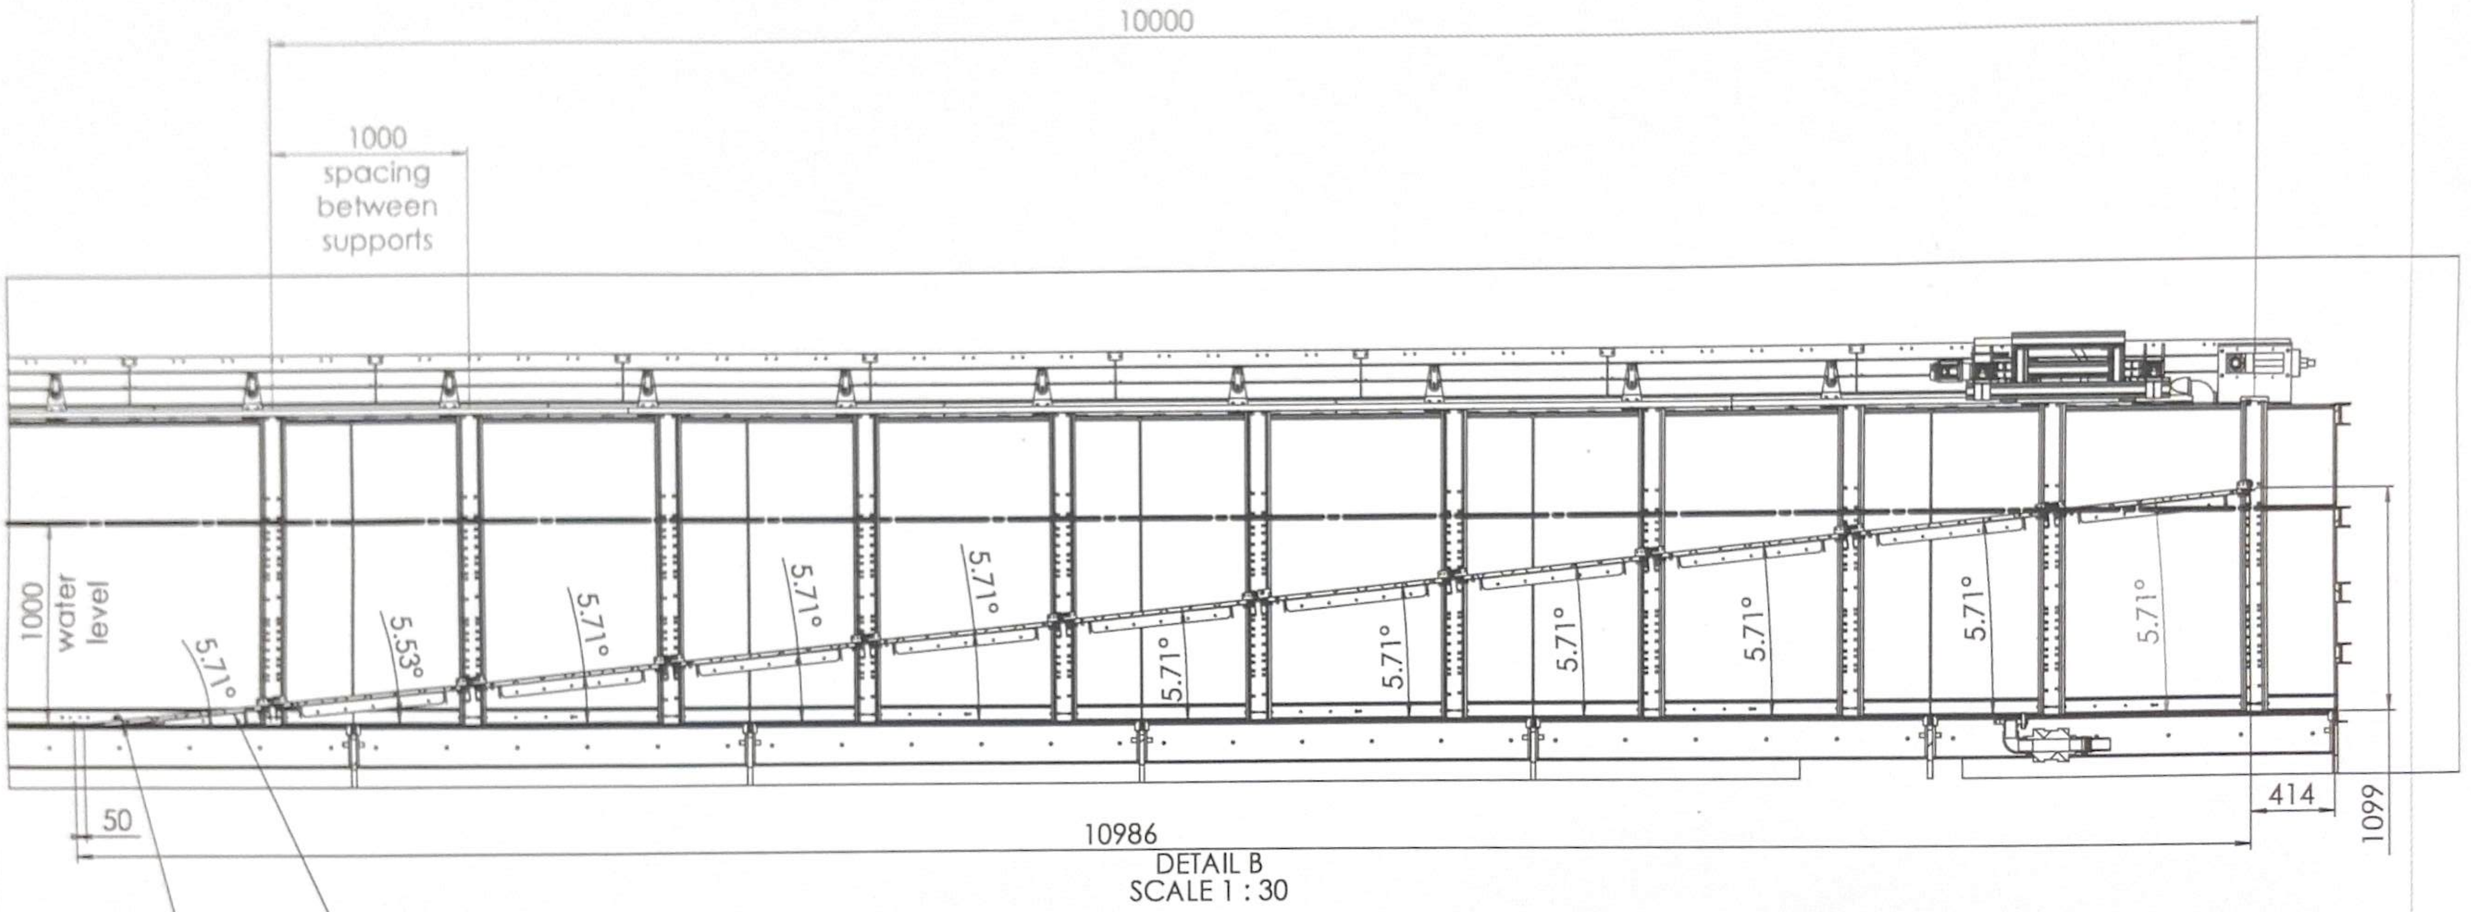

DETAIL B
SCALE 1 : 30

slope 1 in 10

Uses 10 standard beach panels and 1 unique (1 in 10 slope) end beach panel

Dimensions are for information only

DWG NO. North Carolina beach			NCW-GA02
DATE: 03/07/2023		SHEET 2 OF 6	
MATERIAL:		WEIGHT (kg): 215162.9	
FINISH:		All rights reserved. Drawings and specifications are the property and copyright of Edinburgh Designs Ltd. and shall not be reproduced without written agreement of Edinburgh Designs Ltd.	
SCALE: 1:100			
PROJECTION: Third Angle	A3		

EDINBURGH DESIGNS